



ADDENDUM 3

PROJECT NAME: Huebner Creek to Medical Center Trail Park Phase 1 (Floyd Curl to Eckert)

DATE: July 24, 2025

PROJECT NO: 23-04004

This addendum is separated into sections for convenience; however, all respondents, bidders, contractors, subcontractors, material men, and other parties must be responsible for reading the entire addendum. The failure to list an item or items in all affected sections of this addendum does not relieve any party affected from performing as per instructions, providing that the information is set forth one time any place in this addendum. These documents will be attached to and will become part of the Contract Documents for this project. The respondent/bidder is required to acknowledge the receipt of this addendum.

GENERAL:

1. The following changes and/or additions to the Contract Documents, via this addendum, must apply to proposals made for and to the execution of the various parts of the work affected thereby.
2. Careful note of the Addendum must be taken by all interested parties and all trades affected must be fully advised in their performance of the work involved.
3. This Addendum is hereby made part of the project requirements and contract documents for the above reference project. Ensure to acknowledge this Addendum in CivCast when downloading this Addendum. Acknowledgement of this Addendum is a requirement in order to submit bid in CivCast. This addendum consists of the items and their associated attachments as listed below:

A. ADMINISTRATIVE CHANGES TO BID DOCUMENTS:

1. **Current Bid Opening Date: Friday, August 1, 2025**

New Bid Opening Date: Friday, August 8, 2025

B. CHANGES TO PLANS / SPECIFICATIONS:

1. **VOLUME 1 – HUEBNER CREEK GREENWAY. SHEET C310 UPDATED PER RAS REVIEWER COMMENTS. HANDRAIL ADDED AT SEGMENT OF RAMP ON BOTH SIDES. FROM STA: 93+45.86 TO STA: 93+91.78.**

HANDRAIL SHALL BE REQUIRED TO MEET ALL FEDERAL, STATE, AND LOCAL CODES. DETAIL TO BE SIMILAR TO 2/L3323 WITH HANDRAIL MOUNTED 34”-38” TO GUARDRAIL AND MEETING REQUIREMENTS LISTED IN 2012 TEXAS ACCESSIBILITY STANDARDS, SECTION 505.

MATERIAL FOR HANDRAIL SHALL BE GRADE 316 STAINLESS STEEL W/ BRUSHED FINISH.



Jaime E. Contreras

Jaime E. Contreras
Procurement Manager
Finance Department - Procurement Division

END OF ADDENDUM NO. 3

CITY OF SAN ANTONIO

Issued By: Public Works Department
ID NO.: 23-04004

Date Issued: June 20, 2025

(010) LOW QUALIFIED FORMAL INVITATION FOR BIDS (IFB) to CONTRACT Huebner Creek to Medical Center Trail and Park Phase 1 (Floyd Curl to Eckert)

Online bidding is utilized via CivCast at <https://www.civcastusa.com/bids>. Online bid services will open for bidding on **Friday, June 20, 2025** and close on **Friday, August 8, 2025 at 2:00 P.M. (CT)**. Follow submittal instructions on <https://www.civcastusa.com/>. **Hard Copies will not be accepted for this solicitation.** Bids will be opened and the Bid Results will be posted on CivCast on the day of the bid deadline. Bid Results will be read aloud utilizing WebEx. Access WebEx by phone at **1-415-655-0001** and/or <https://www.webex.com/> with Access Code: 1770 23 1452, Password: 3HrMPWvWr58

A Non-Mandatory Pre-bid meeting will be held through WebEx on **Tuesday, July 1, 2025 at 10:00 A.M. (CT)**. Access the WebEx by phone at **1-415-655-0001** and/or <https://www.webex.com/> with Access Code: 2335 385 1395, Password: mTQJN6F9Qw2. Additionally, a non-mandatory **Site Visit** will be held at **2:00 P.M. Central Time, on Tuesday, July 1, 2025:**

Site Visiting Staging Location (gravel parking lot next to Take 5 Oil Change)
5719 Babcock Rd. San Antonio, TX 78240

The Deadline for questions is scheduled for Friday, July 11, 2025 at 4:00 P.M. (CT).

The estimated construction budget for this contract is \$10,809,000.00, with 11 Alternates.

Bidder acknowledges that this is a unit price or Lump Sum contract; that prices established will remain in effect and valid throughout the duration of the contract; the quantities shown are estimated quantities for budgetary purposes only; the award of this contract does not guarantee contractor the entire work shown in this FORMAL INVITATION FOR BID (IFB); the City of San Antonio (City) may order all, some, or none of the work shown in this IFB. **City may elect to award this Project based solely on the base bid, based on a combination of the base bid plus any combination of selected alternates or based on a combination of the base bid plus all alternates that serve the best interest of City. All bids must include a price for all units or line items, including any alternates. Entering a price of "\$0.00" shall mean the units or line items will be provided at no cost to City. A unit price left blank shall result in the bid being deemed nonresponsive and disqualified from consideration. City reserves the right to delete line items prior to award.**

This invitation includes the following Contract Documents which are required downloads in CivCast:

010	Invitation for Bids	081	General Conditions for Construction Contracts
020	Contract Signature Page	■	Subcontractor/Supplier Utilization Plan
024	Unit Pricing Form (Lump Sum Bid Only)	■	Local Preference Program Identification Form
030	Experience & Qualifications Form w/Project Sheets	■	VOSB Program Tracking Form
040	Standard Instructions to Respondent	■	Wage Decision
041	Certificate of Interested Parties (TEC Form 1295)	■	Insurance Requirements
050.01	SBEDA Guidelines	■	Heat Illness Prevention Acknowledgment Form
060	Supplemental Conditions		
075	Performance Bond		
076	Payment Bond		

The City of San Antonio point of contact for this solicitation is **Procurement Specialist II, Desiree Alderete**, desiree.alderete@sanantonio.gov. Questions are to be submitted in writing in the Questions and Answers section on CivCast. Bidder understands and agrees to the responsibility for obtaining any and all addenda and adhering to all requirements in addenda. City is not responsible for incorrect information obtained through other sources.

Bid Documents must contain "**Legal Name of Company**" as listed by the Texas Secretary of State Registry (<http://www.sos.state.tx.us/>). The documents required in CivCast (fully completed and with digital signatures) constitute the required information to be submitted as a part of the bid proposal.

The following documents constitute the required information to be submitted as a part of the bid proposal and are required uploads in CivCast:

020	Contract Signature Page	■	TEC Form 1295 Certification Number & Date
024	Unit Pricing Form (Lump Sum Bid Only)	■	Local Preference Program Identification Form
030	Experience & Qualifications Form w/Project Sheets	■	VOSB Program Tracking Form
■	Bid Bond	■	Heat Illness Prevention Acknowledgment Form
■	Subcontractor/Supplier Utilization Plan		

It is understood and agreed that the work is to be substantially completed on or before 600 calendar days. This project **does not** include hazardous environmental work. This project requires 4 project sign(s).

Small Business Economic Development Advocacy (SBEDA) Program – Respondents shall meet the subcontracting requirements as stated on 050.01 Form and on the *Subcontractor/Supplier Utilization Plan* posted with this solicitation on the City’s website. The *Subcontractor/Supplier Utilization Plan* will be determined off of the base bid amount.

Local Preference Program Ordinance – For more detailed information on the Local Preference Program Ordinance, see solicitation document “040 Standard Instructions to Respondent”, section 5.



Veteran-Owned Small Business Preference Program – For more detailed information on the Veteran-Owned Small Business Preference Program, see Ordinance No. 2013-12-05-0864 and solicitation document “040 Standard Instructions to Respondent”, section 6.

Responsible Bidder Ordinance – For more detailed information on the Responsible Bidder Ordinance, see Ordinance No. 2023-01-26-0041 and solicitation document “040 Standard Instructions to Respondent”, section 7.

Heat Illness Ordinance – For more detailed information on the Heat Illness Ordinance, see Ordinance No. 2023-08-31-0585 and General Conditions for Construction Contract, Article X.1.5 and Art.X.2.3(a).


Bid Protest Procedures – See solicitation document “040 Standard Instructions to Respondent”, section 11.

Wage Decision – Bidder shall meet the prevailing wage rate requirements established for this contract and shall reference the wage decision posted with this solicitation on the City’s website.

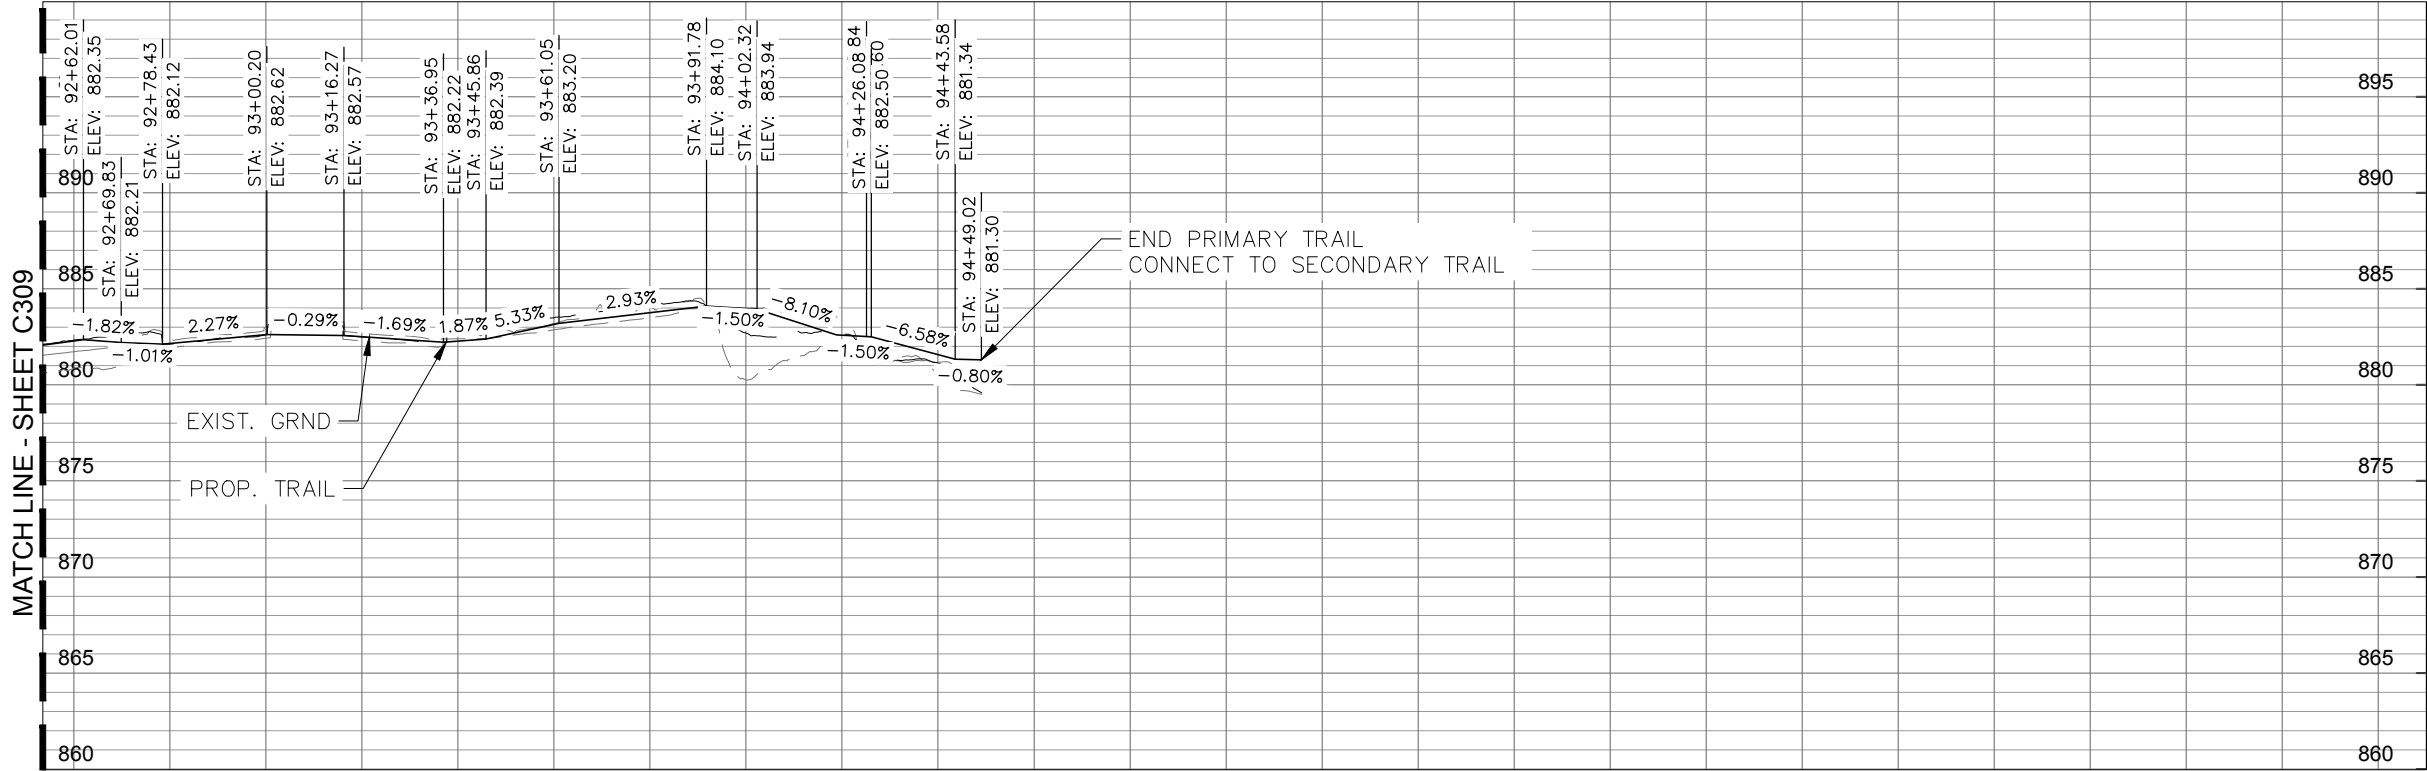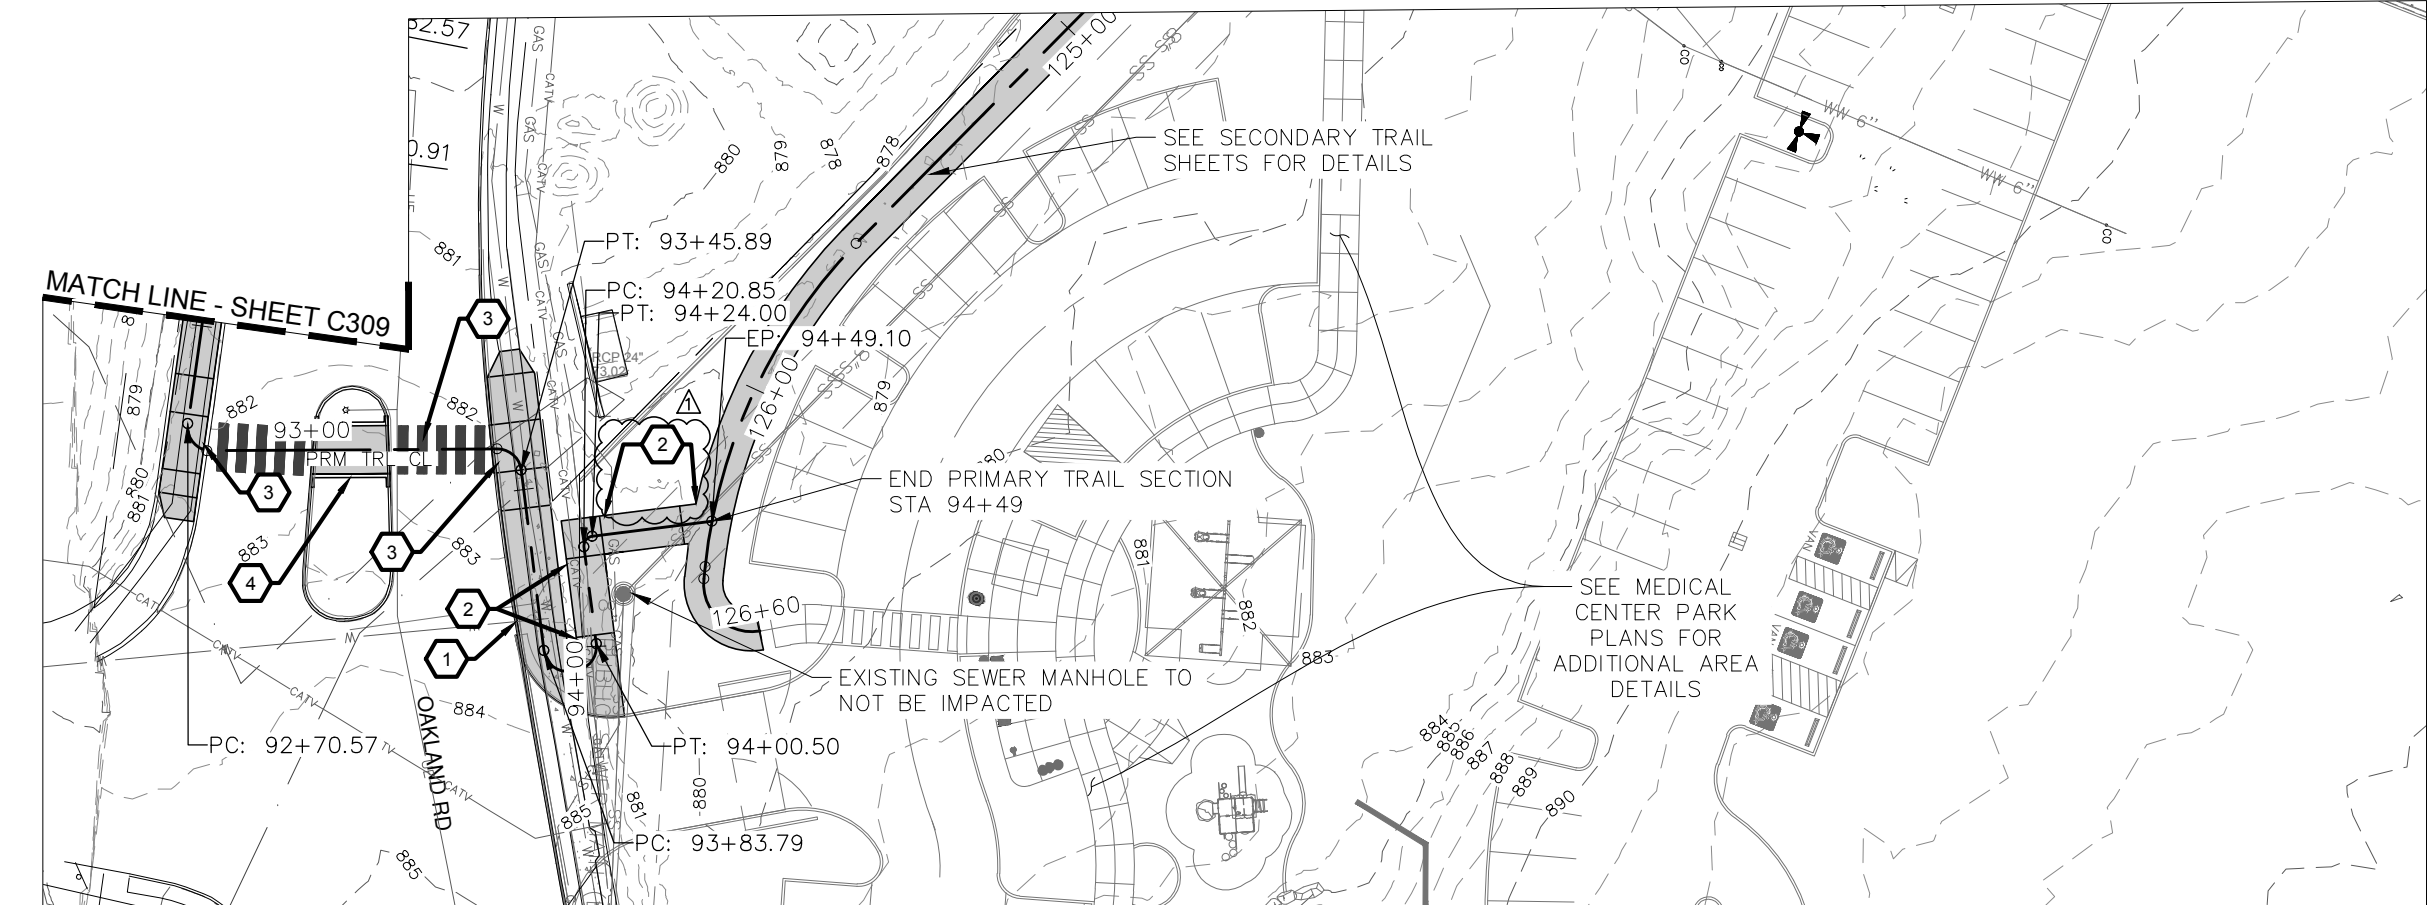

882.01	882.29	882.33	PROPOSED EXISTING	882.16	882.13	882.61	882.61	882.51	882.50	882.28	882.76	883.14	883.50	883.75	884.21	883.98	882.70	882.59	882.65	881.58	881.13
92+60	92+80	93+00	93+20	93+40	93+60	93+80	94+00	94+20	94+40												

1	RAS REVIEW	JM	SD	22JUL25
NO.	REVISION	DRWN	CHKD	DATE

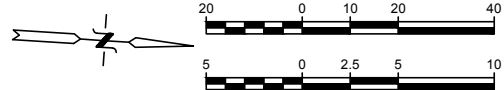

SCALE:
HORIZ 1" = 40'
VERT 1" = 10'


LEGEND

- EXISTING POWER POLE
- EXISTING GUY WIRE
- EXISTING SANITARY SEWER MANHOLE
- EXISTING SIGN
- EXISTING TREE
- EXISTING SHRUB
- PROPERTY LINE
- EXISTING CONTOURS
- EXISTING OVERHEAD ELECTRIC
- EXISTING HIGH VOLTAGE ELECTRIC LINE
- EXISTING SANITARY SEWER LINE
- EXISTING GAS LINE
- EXISTING CHAIN LINK FENCE
- EXISTING WATER LINE
- PROPOSED CONCRETE TRAIL

KEY NOTES

- PROPOSED 8' WIDE 5" THICK CONCRETE WALK WITH 24" TOE DOWN. SEE SITE DETAILS FOR TRAIL AND AESTHETIC DETAILS.
- PROPOSED 8' WIDE 5" THICK CONCRETE RAMP WITH HANDRAIL AND 24" TOE-DOWN.
- PROPOSED ADA RAMP. SEE SITE DETAILS
- PROPOSED TXDOT CURB RAMP 21

CAUTION
UTILITIES SHOW ARE APPROXIMATE LOCATIONS. CONTRACTOR IS RESPONSIBLE FOR COORDINATING, VERIFYING EXACT LOCATION AND IDENTIFYING AREAS WITH UTILITY CONFLICTS. UTILITY CONFLICTS WILL BE NOTIFIED TO PROJECT TEAM IMMEDIATELY WHEN FOUND.

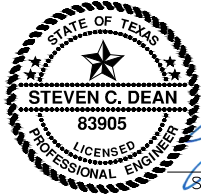

STEVEN C. DEAN, P.E. 07/22/2025
DATE



SAN ANTONIO | AUSTIN | HOUSTON | FORT WORTH | DALLAS
2000 NW LOOP 410 | SAN ANTONIO, TX 78213 | 210.375.9000
TBP# FIRM REGISTRATION #470 | TBP# FIRM REGISTRATION #10028800



TBG



HUEBNER CREEK GREENWAY VOL. 1
FLOYD CURL RD TO BABCOCK RD
TRAIL PLAN AND PROFILES
PRIMARY TRAIL-STA 92+50 TO END

100 % SUBMITTAL	PROJECT NO.: S22422	DATE: 03/21/2025
DRWN. BY: RG	DSGN. BY: JEM	CHKD. BY: SD

SHEET NO.: C310